


**SUITE 185
AVAILABLE
2,058 SF**

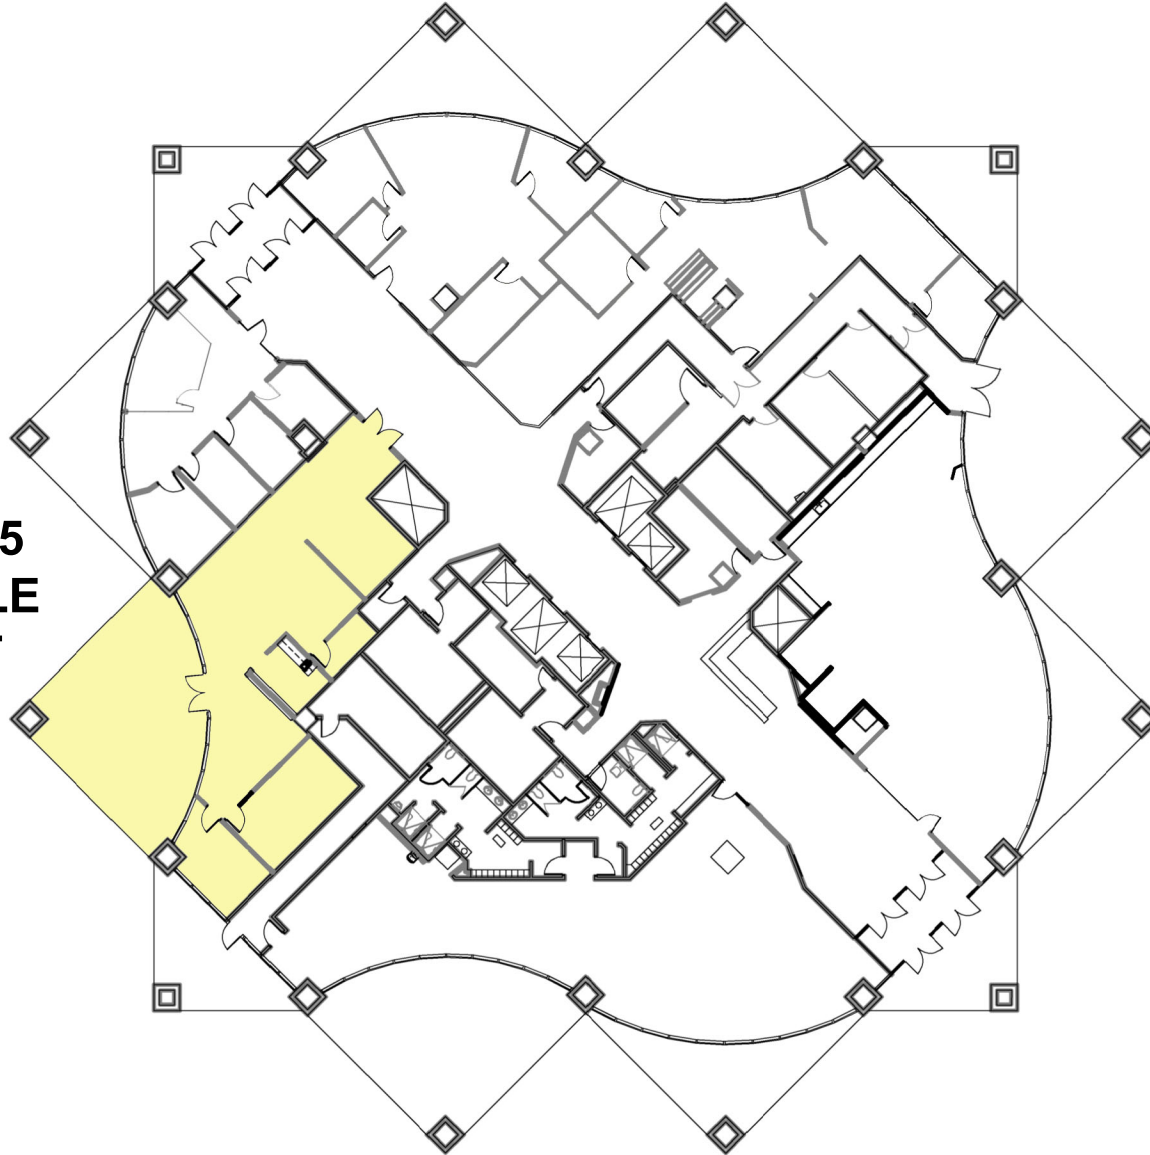

[SCALE]
not to scale

As-Built

Landmark Center, 1st Floor
1099 N. Meridian St. Indianapolis, IN

[PROJ. #]
2014.500

[DATE]
04.16.20