


**SUITE 310
AVAILABLE
17,766 SF**

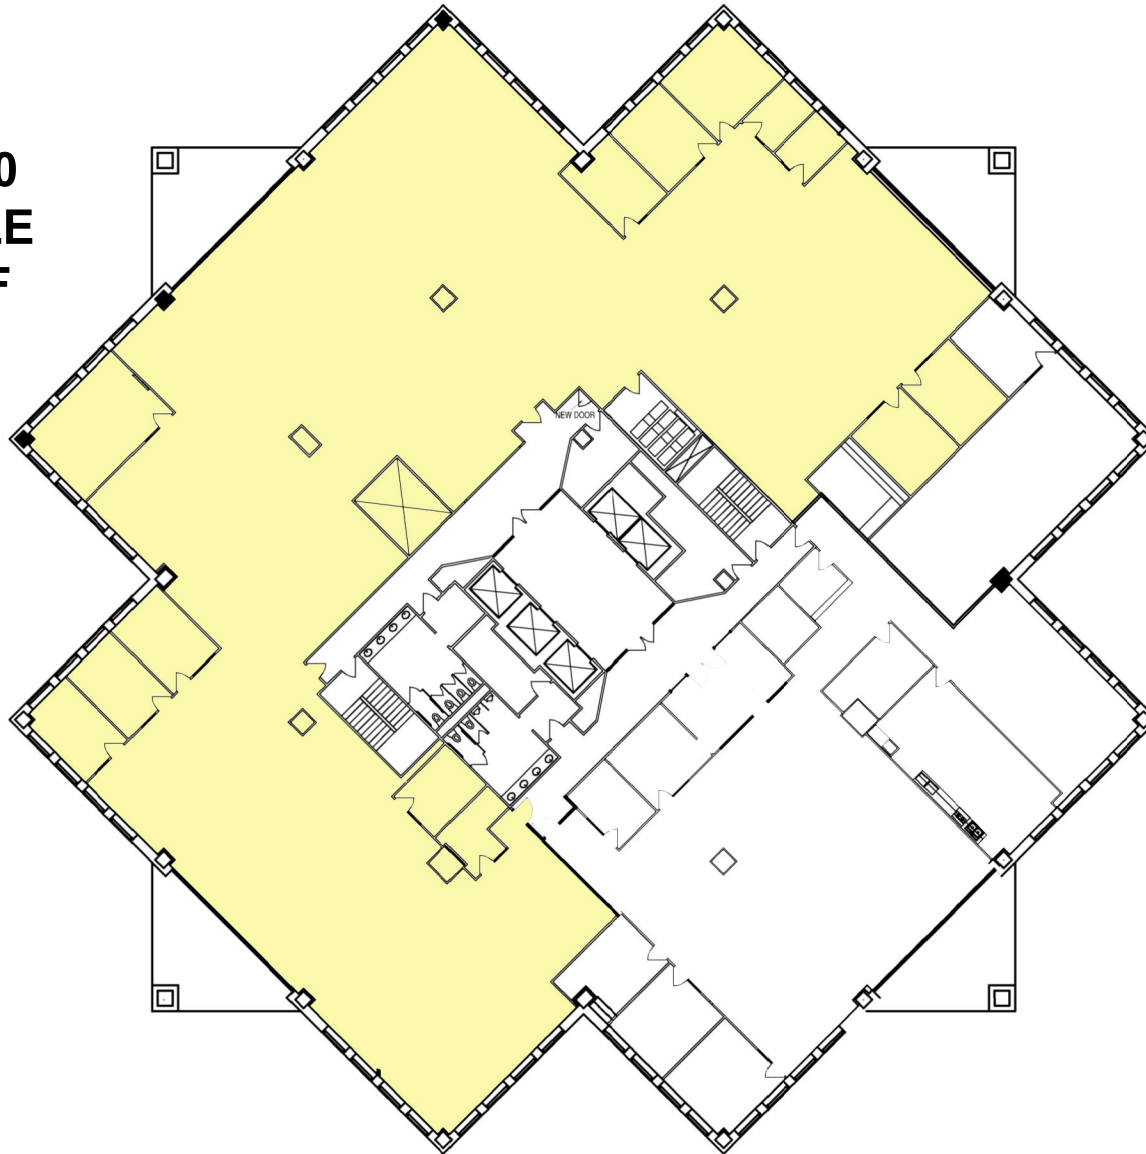

[RENTABLE SQ.FT.]

[SCALE]
Not to Scale

As-Built
LANDMARK CENTER - 3rd Floor
1099 N. Meridian St.
Indianapolis, IN

[PROJ. #]
2014.500

[DATE]
04.16.20


PARALLEL
DESIGN
GROUP