


**SUITE 1100
AVAILABLE
25,688 SF**

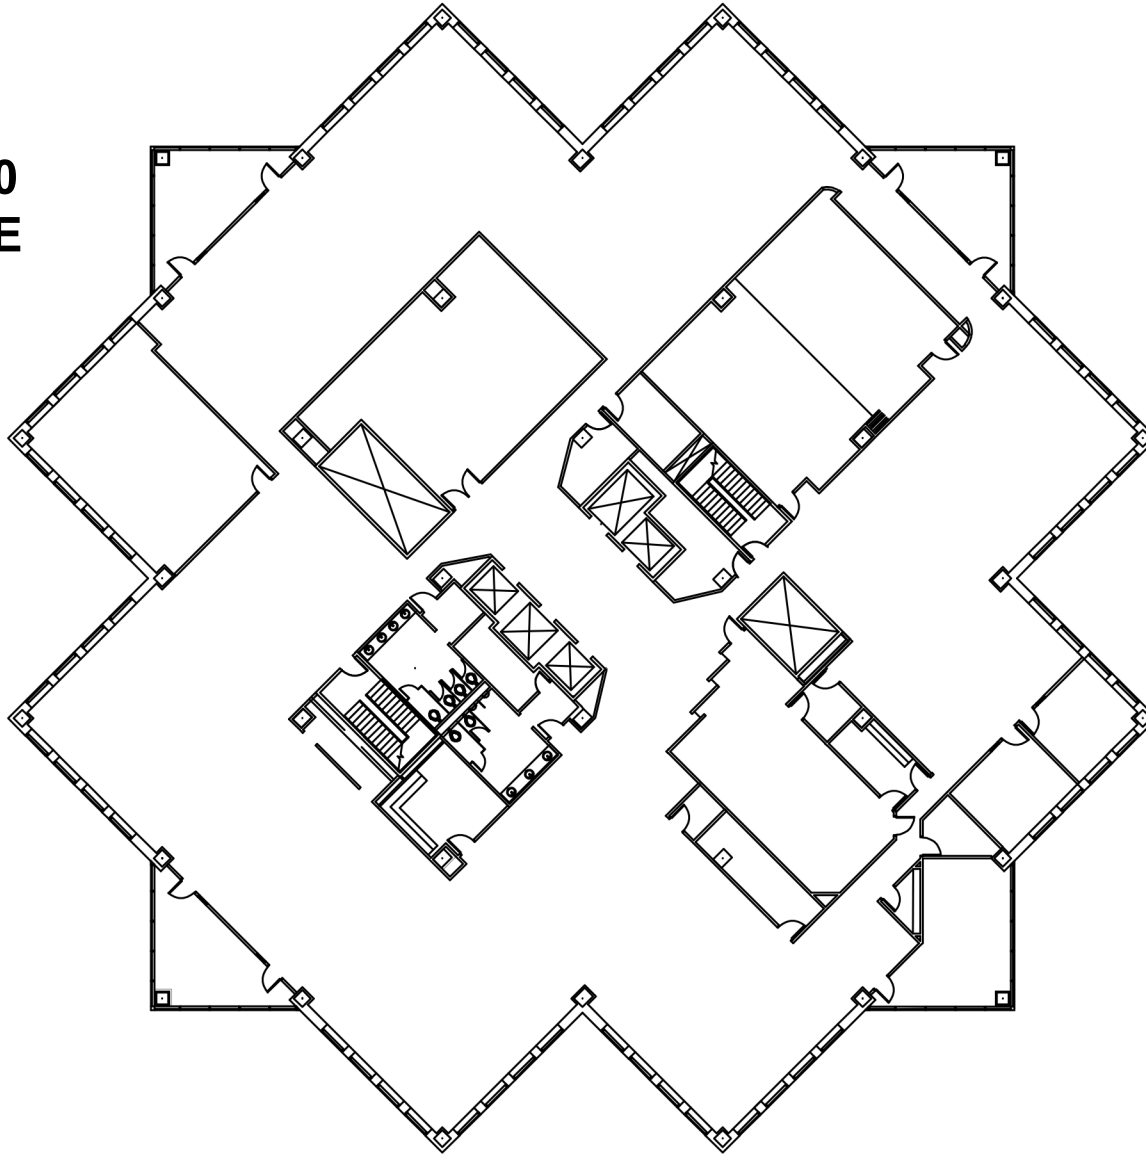

[RENTABLE SQ.FT.]

[SCALE]
not to scale

As-Built

Landmark Center, 11th Floor
1099 N. Meridian St. Indianapolis, IN

[PROJ.#]
2014.500

[DATE]
04.16.20

